

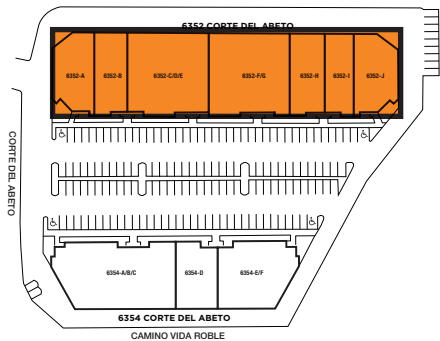
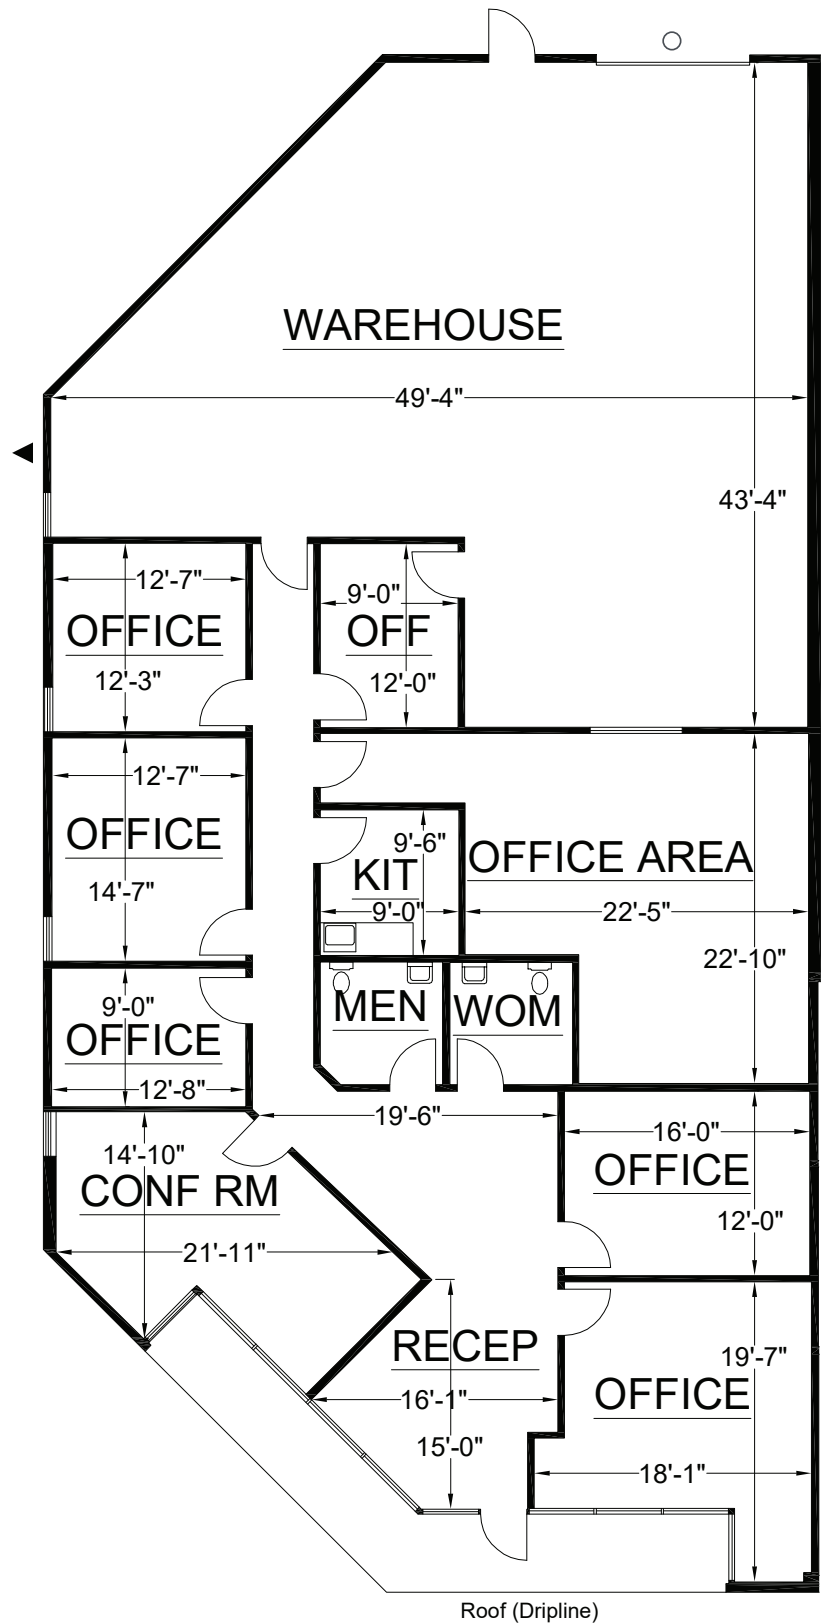
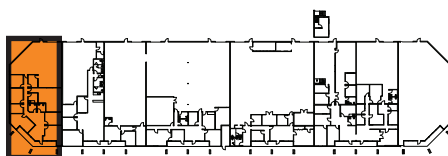
SUITE DATA:

OFFICE AREA	SF
WAREHOUSE AREA	SF
TOTAL SUITE AREA	4,250 SF

CLEAR HEIGHT	16'-0"
--------------	--------

○ GRADE LEVEL DOORS	1
---------------------	---

▲ DOCK HIGH DOORS	1
-------------------	---

SITE KEY PLAN:**BUILDING KEY PLAN:**

Arroyo Business Center

6352 Corte Del Abeto
Carlsbad, CA 92011

BLDG. 6352

STE A

07/01/19

